EASTERN RAILWAY :: BARANAGAR

CABLE ROUTE LOCATION LAYOUT DIAGRAM : SIGNAL & 4 QUAD

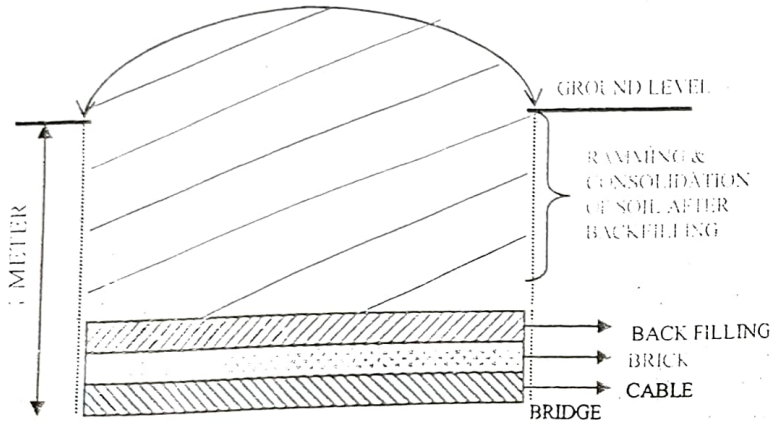

B . ARUP & CO.
8/4B , SASHI BHUSAN CHATTERJEE LANE)
KOLKATA - 700002

PHONE :: 2555 - 9680

B . ARUP & CO	CABLE LAYING PLAN	B. ARUP & CO	SSE / S / CON / SDAH	DSTE / CON / SDAH	DRAWING NO	SHEET NO
8 / 4B , SASHI BHUSAN CHATTERJEE LANE . KOLKATA - 700002	PROJECT :: BARANAGAR	C. S. Basak		17.12.07	B. A & CO / BARN / 08 / 2K7	PAGE 1 OF 6
	EASTERN RAILWAY :: SEALDAH	PREPARED BY	CHECKED BY	APPROVED BY		

TRENCHING , CABLE LAYING AND BACK FILLING ARRANGEMENT

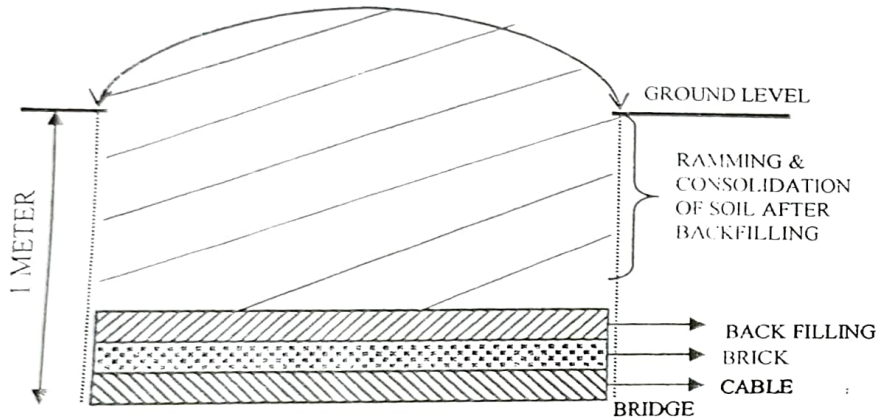

DETAILS OF TRENCHING & CABLE LAYING

SIGNAL LOCATTION

BRIDGE

PLATFORM

ABBREVIATION OF SYMBOL :

TRACK

CABLE ROUTE

PUCCA / KUTCHA ROAD

P & T PO ST

GI / RCC PIPE

L C GATE

SM ROOM

CULVERT

B . ARUP & CO - 8 / 4B , SASHI BHUSAN CHATTERJEE LANE . KOLKATA - 700002	CABLE LAYING PLAN PROJECT :: BARANAGAR EASTERN RAILWAY :: SEALDAH	B. ARUP & CO C. S. Basak PREPARED BY	SSE / S / CON / SDAH CHECKED BY	DSTE / CON / SDAH APPROVED BY	DRAWING NO B. A & CO / BARN / 08 / 2K7	SHEET NO PAGE 2 OF 6

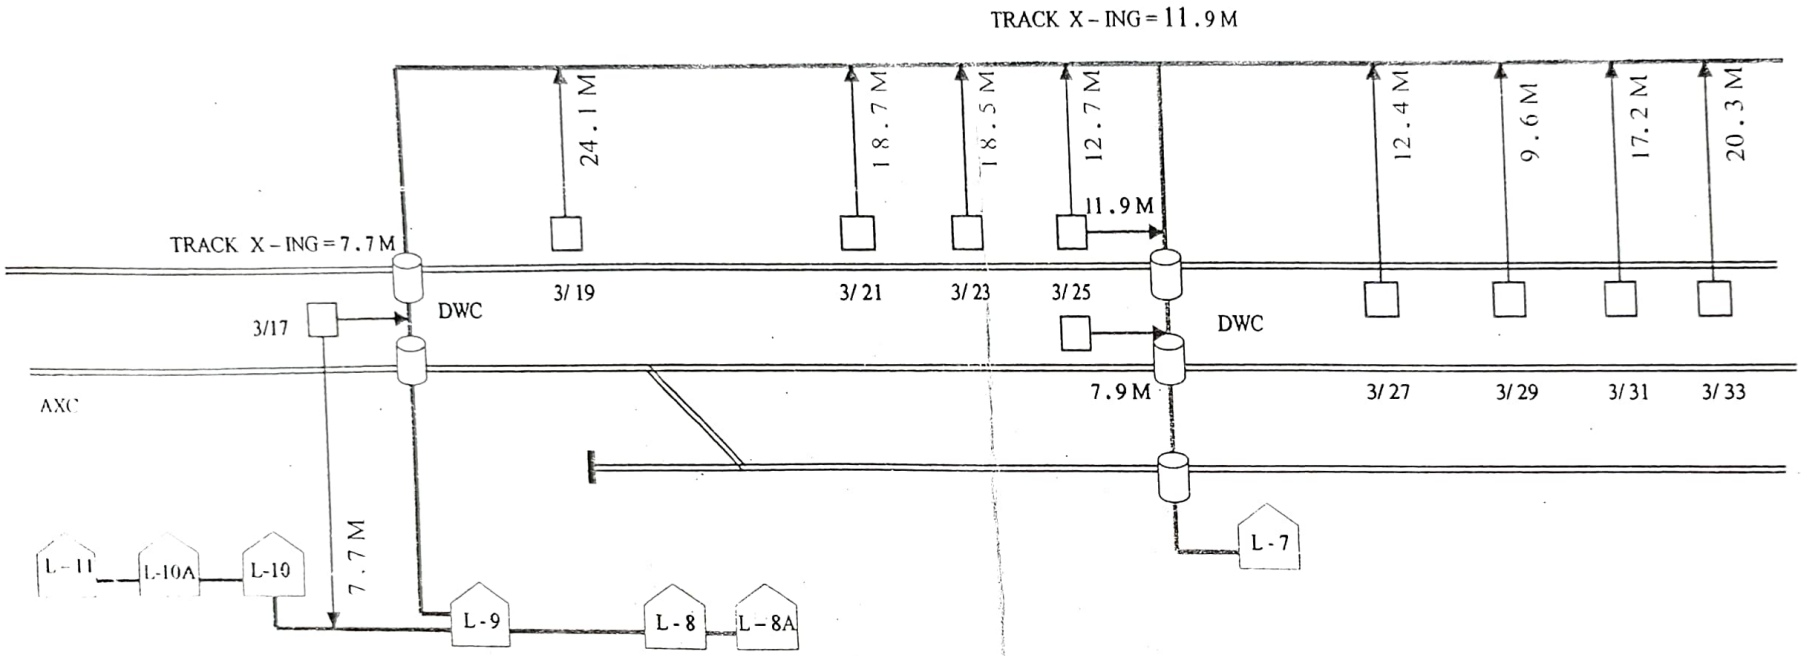

B. ARUP & CO 8/4B, SASHI BHUSAN CHATTERJEE LANE. KOLKATA - 700002	CABLE LAYING PLAN PROJECT :: BARANAGAR EASTERN RAILWAY :: SEALDAH	B. ARUP & CO C.S. Basak PREPARED BY	~~SSE~~ / S / CON / SDAH CHECKED BY	DSTE / CON / SDAH 17.8.07 APPROVED BY	DRAWING NO B. A & CO / BARN / 08 / 2K7	SHEET NO PAGE ~~3~~ 3 6 OF ~~3~~

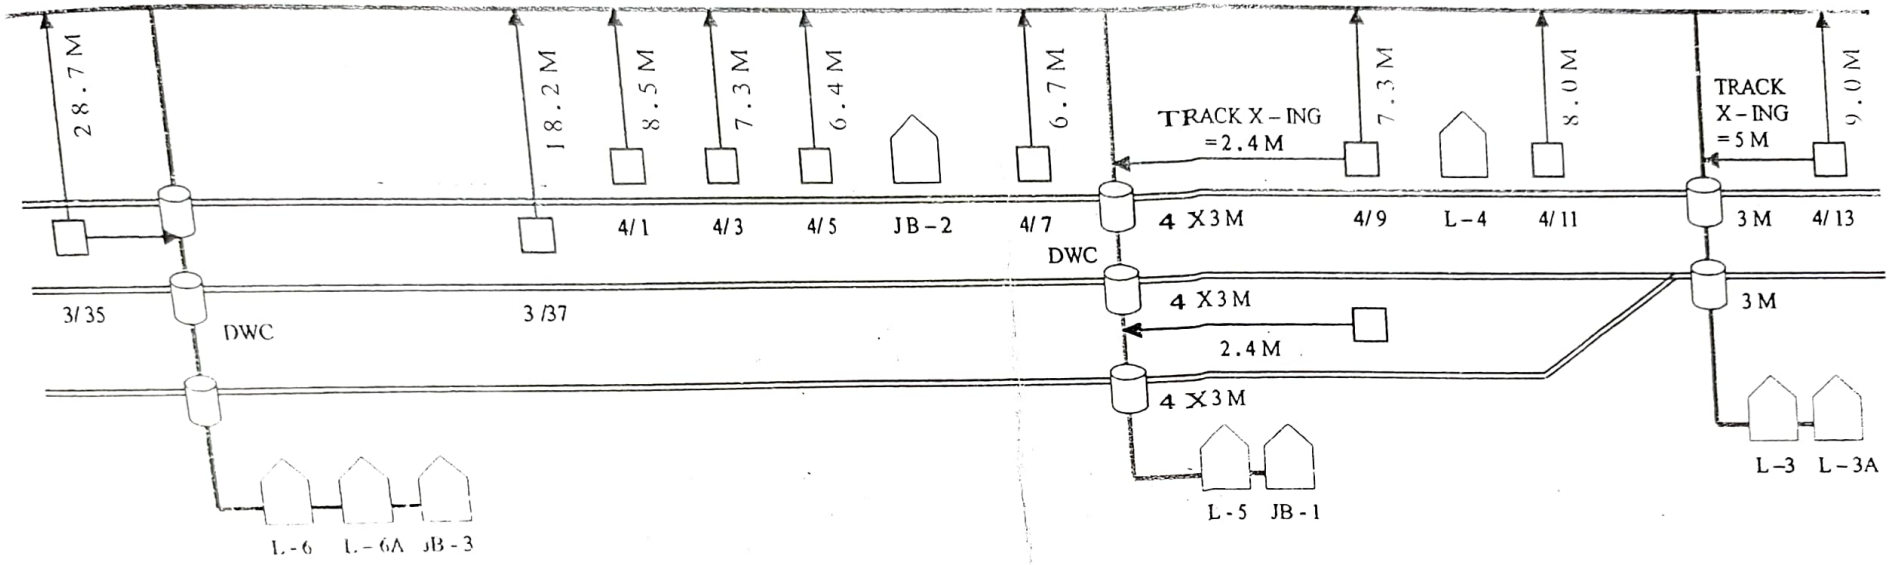

B. ARUP & CO 8/4B, SASHI BHUSAN CHATTERJEE LANE. KOLKATA - 700002	CABLE LAYING PLAN PROJECT :: BARANAGAR EASTERN RAILWAY :: SEALDAH	B. ARUP & CO PREPARED BY	SE/S/CON/SDAH CHECKED BY	DSTE/CON/SDAH APPROVED BY	DRAWING NO B. A & CO/BARN/08/2K7	SHEET NO PAGE 4 OF 6

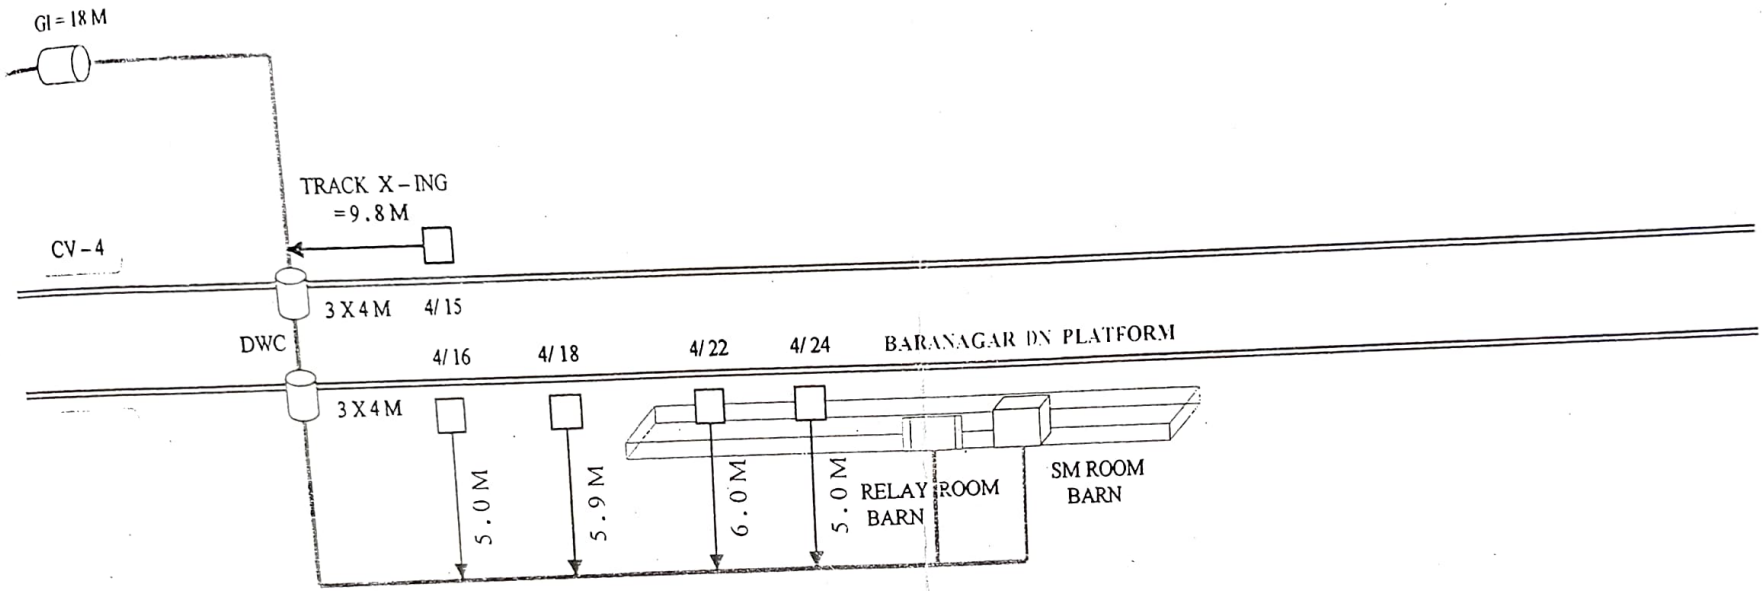

B. ARUP & CO	CABLE LAYING PLAN	B. ARUP & CO	SE / S / CON / SDAH	DSTE / CON / SDAH	DRAWING NO	SHEET NO
8/4B, SASHI BHUSAN CHATTERJEE LANE. KOLKATA - 700002	PROJECT :: BARANAGAR	C. S. Barak		17.12.08	B. A & CO / BARN / 08 / 2K7	PAGE 5 OF 6
	EASTERN RAILWAY :: SEALDAH	PREPARED BY	CHECKED BY	APPROVED BY		

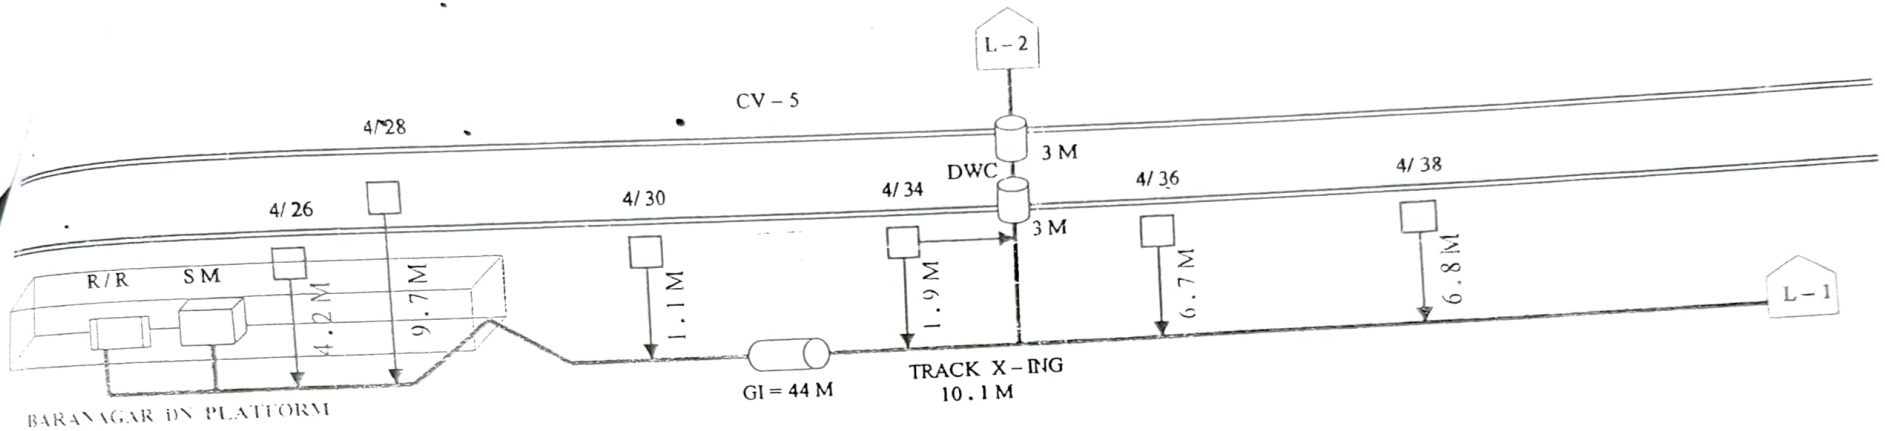

B. ARUP & CO 8/4B, SASHI BHUSAN CHATTERJEE LANE. KOLKATA - 700002	CABLE LAYING PLAN PROJECT :: BARANAGAR EASTERN RAILWAY :: SEALDAH	B. ARUP & CO C.S Barrack PREPARED BY	SE / S / CON / SDAH CHECKED BY	DSTE / CON / SDAH APPROVED BY	DRAWING NO B. A & CO / BARN / 08 / 2K7	SHEET NO PAGE 6 OF 6